


SCHMITT CONSTRUCTION
 2900 HEINZ ST., SACRAMENTO, CA 95826-3891
 PHONE: (916) 457-6855 FAX: 457-6510

REMARKS	BY
Δ 9/25/08	TSA

SUNSET ROCKLIN TOWNHOUSES
 2500 Chalmette Ct., Rocklin, Ca. 95677
 Landscape Irrigation Plan
 PROJECT SHEET TITLE

DATE:	08-27-08
DESIGN BY:	ISC
DRAWN BY:	ISC
SCALE:	1"=20'
SHEET No.	L-4

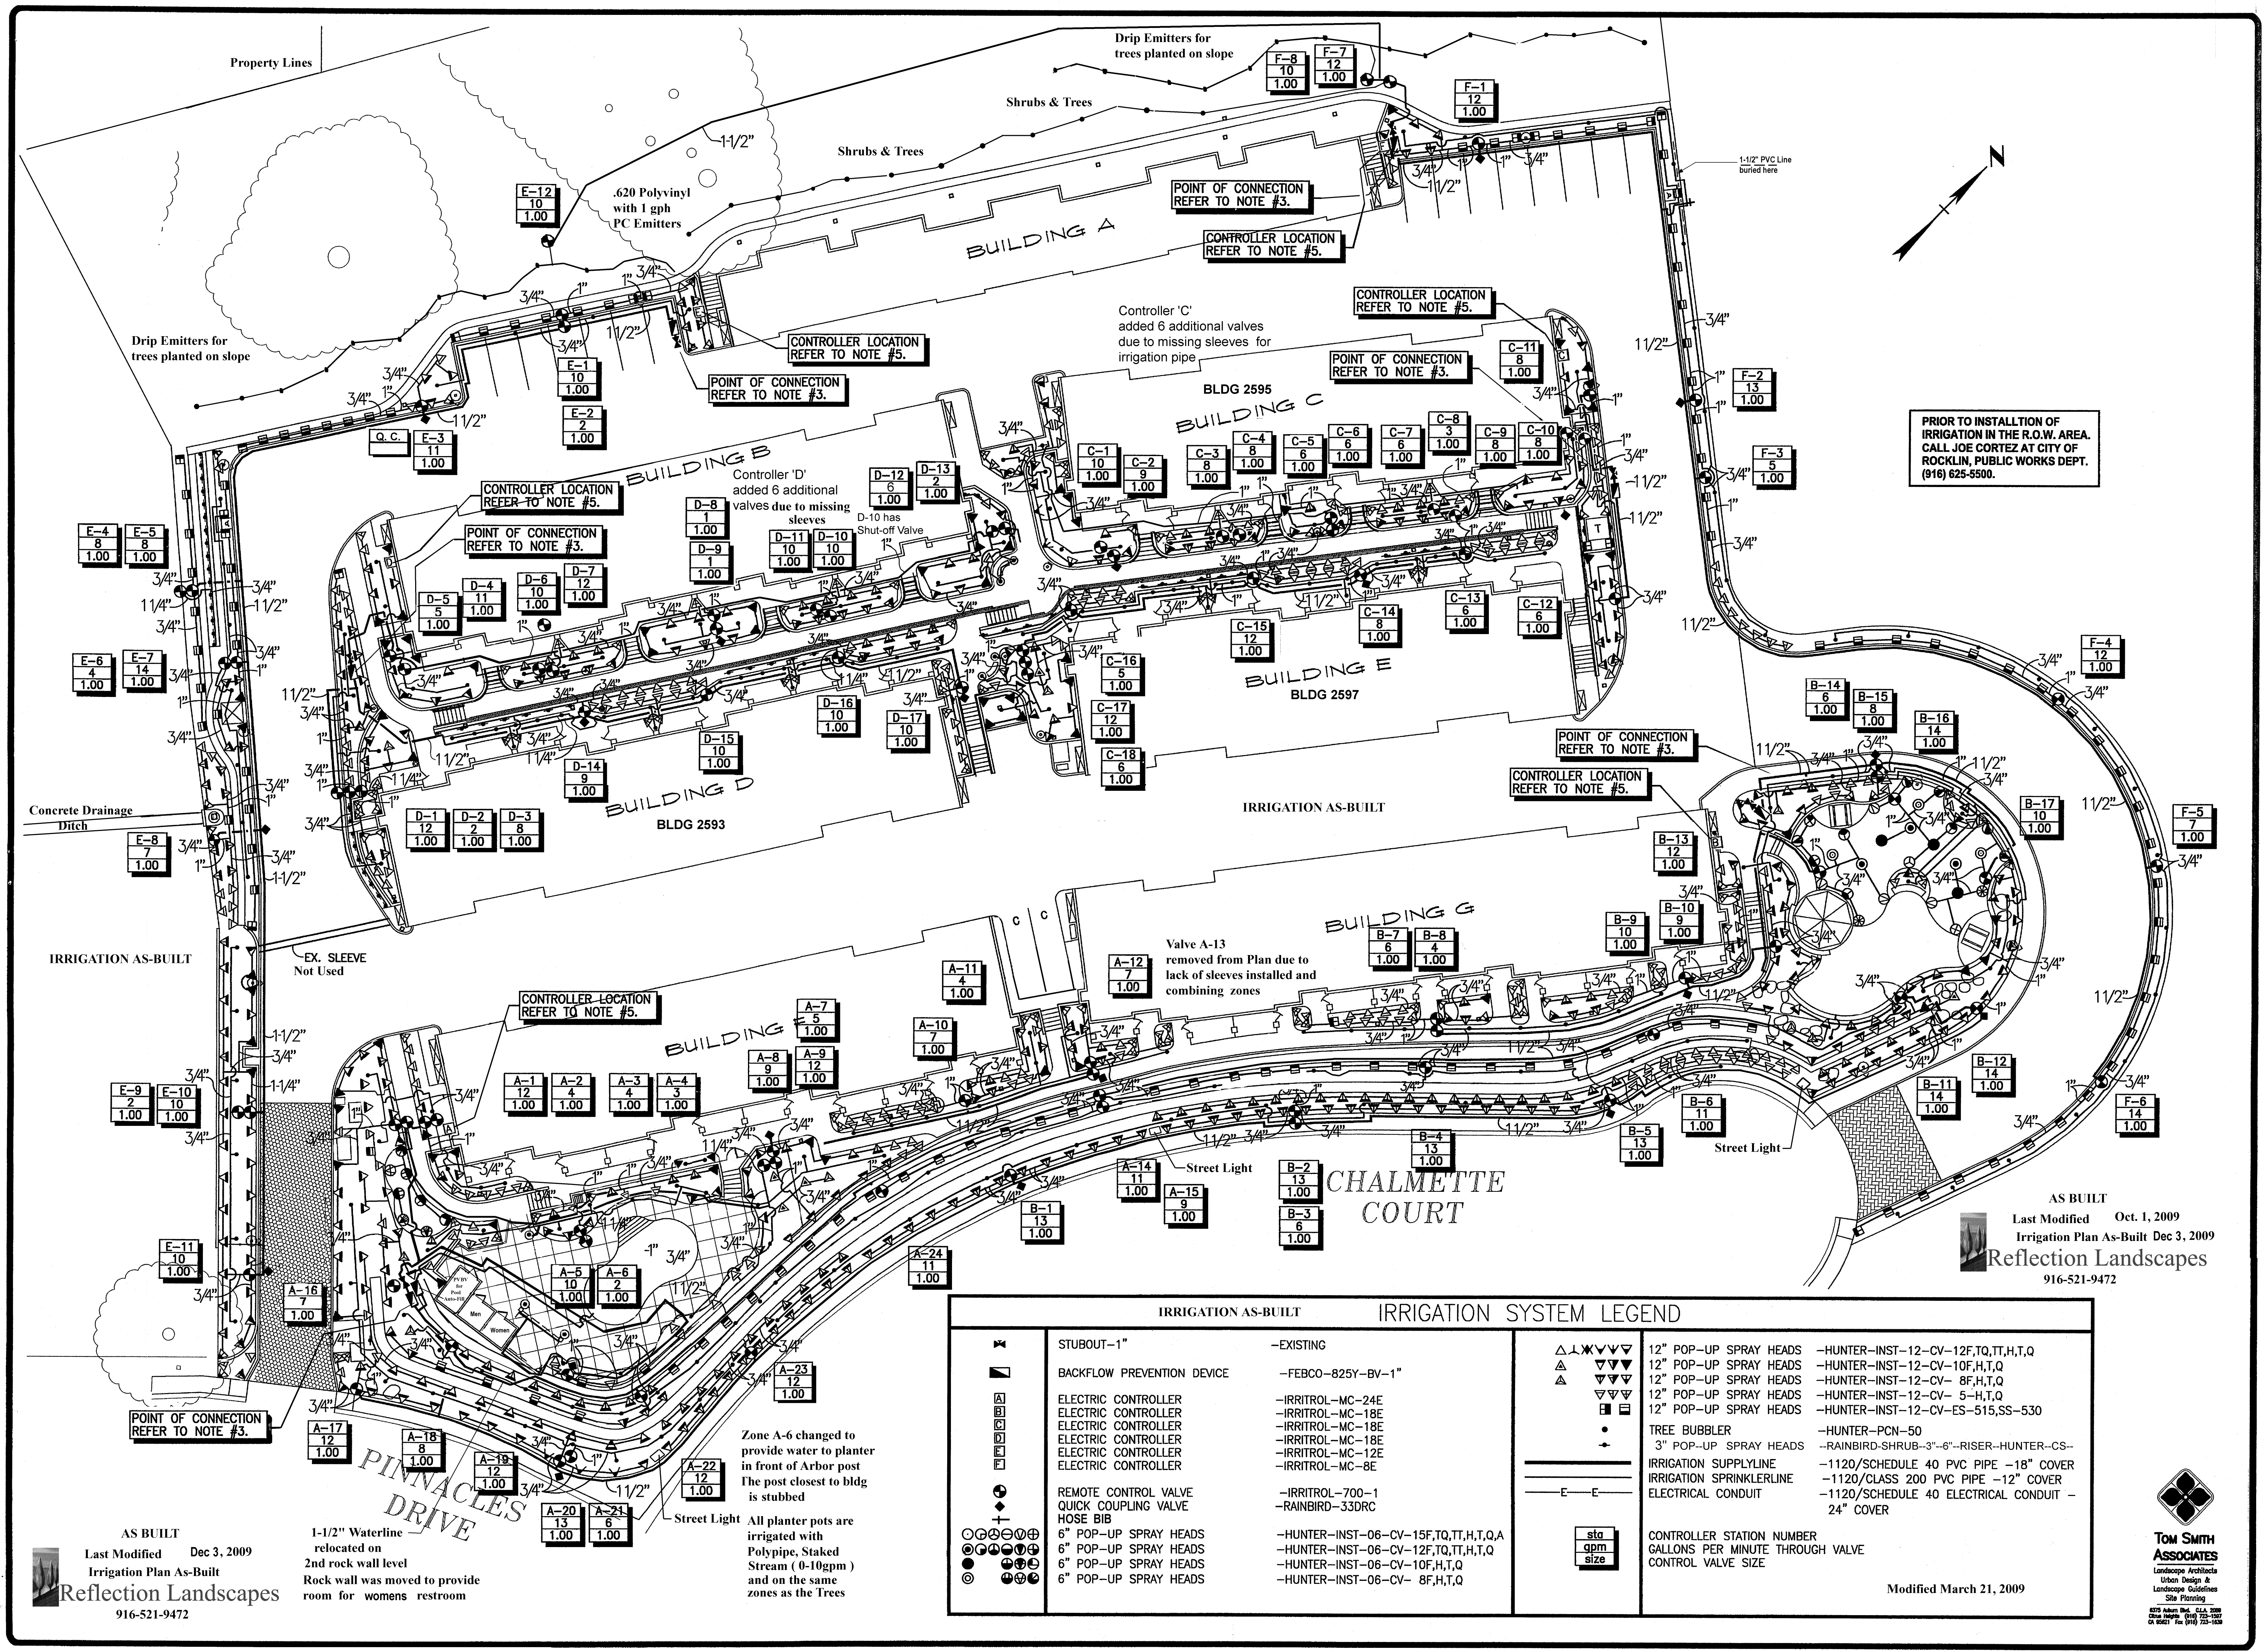

IRRIGATION AS-BUILT IRRIGATION SYSTEM LEGEND

	STUBOUT-1"		-EXISTING		12" POP-UP SPRAY HEADS	-HUNTER-INST-12-CV-12F,TQ,TT,H,T,Q
	BACKFLOW PREVENTION DEVICE		-FESCO-825Y-BV-1"		12" POP-UP SPRAY HEADS	-HUNTER-INST-12-CV-10F,H,T,Q
	ELECTRIC CONTROLLER		-IRRITROL-MC-24E		12" POP-UP SPRAY HEADS	-HUNTER-INST-12-CV-8F,H,T,Q
	ELECTRIC CONTROLLER		-IRRITROL-MC-18E		12" POP-UP SPRAY HEADS	-HUNTER-INST-12-CV-5-H,T,Q
	ELECTRIC CONTROLLER		-IRRITROL-MC-18E		12" POP-UP SPRAY HEADS	-HUNTER-INST-12-CV-ES-515,SS-530
	ELECTRIC CONTROLLER		-IRRITROL-MC-12E		TREE BUBBLER	-HUNTER-PCN-50
	ELECTRIC CONTROLLER		-IRRITROL-MC-8E		3" POP-UP SPRAY HEADS	-RAINBIRD-SHRUB-3"-6"-RISER-HUNTER-CS-
	REMOTE CONTROL VALVE		-IRRITROL-700-1		IRRIGATION SUPPLYLINE	-1120/SCHEDULE 40 PVC PIPE -18" COVER
	QUICK COUPLING VALVE		-RAINBIRD-33DRC		IRRIGATION SPRINKLERLINE	-1120/CLASS 200 PVC PIPE -12" COVER
	HOSE BIB				ELECTRICAL CONDUIT	-1120/SCHEDULE 40 ELECTRICAL CONDUIT - 24" COVER
	6" POP-UP SPRAY HEADS		-HUNTER-INST-06-CV-15F,TQ,TT,H,T,Q,A		CONTROLLER STATION NUMBER	GALLONS PER MINUTE THROUGH VALVE
	6" POP-UP SPRAY HEADS		-HUNTER-INST-06-CV-12F,TQ,TT,H,T,Q		CONTROL VALVE SIZE	
	6" POP-UP SPRAY HEADS		-HUNTER-INST-06-CV-10F,H,T,Q			
	6" POP-UP SPRAY HEADS		-HUNTER-INST-06-CV-8F,H,T,Q			

Modified March 21, 2009

